



- NOTES:
1. DRAWINGS ARE NOT TO BE SCALED.
 2. THESE DRAWINGS ARE NOT FOR CONSTRUCTION.
 3. ALL DIMENSIONS AND INSTALLATIONS ARE TO BE VERIFIED ON SITE.
 4. VERIFY ANY MISSING OR CONFLICTING DIMENSIONS WITH THE DESIGNER OR GENERAL CONTRACTOR PRIOR TO CONSTRUCTION.

PROJECT:

ADDRESS:
1561 WESTCHESTER
BOURNE

DRAWING TITLE:
AS BUILT PLAN

DATE:
06/29/2026


SCALE:
1/4" = 1'-0"

NORTH:



DRAWING NO:


1 OF 2

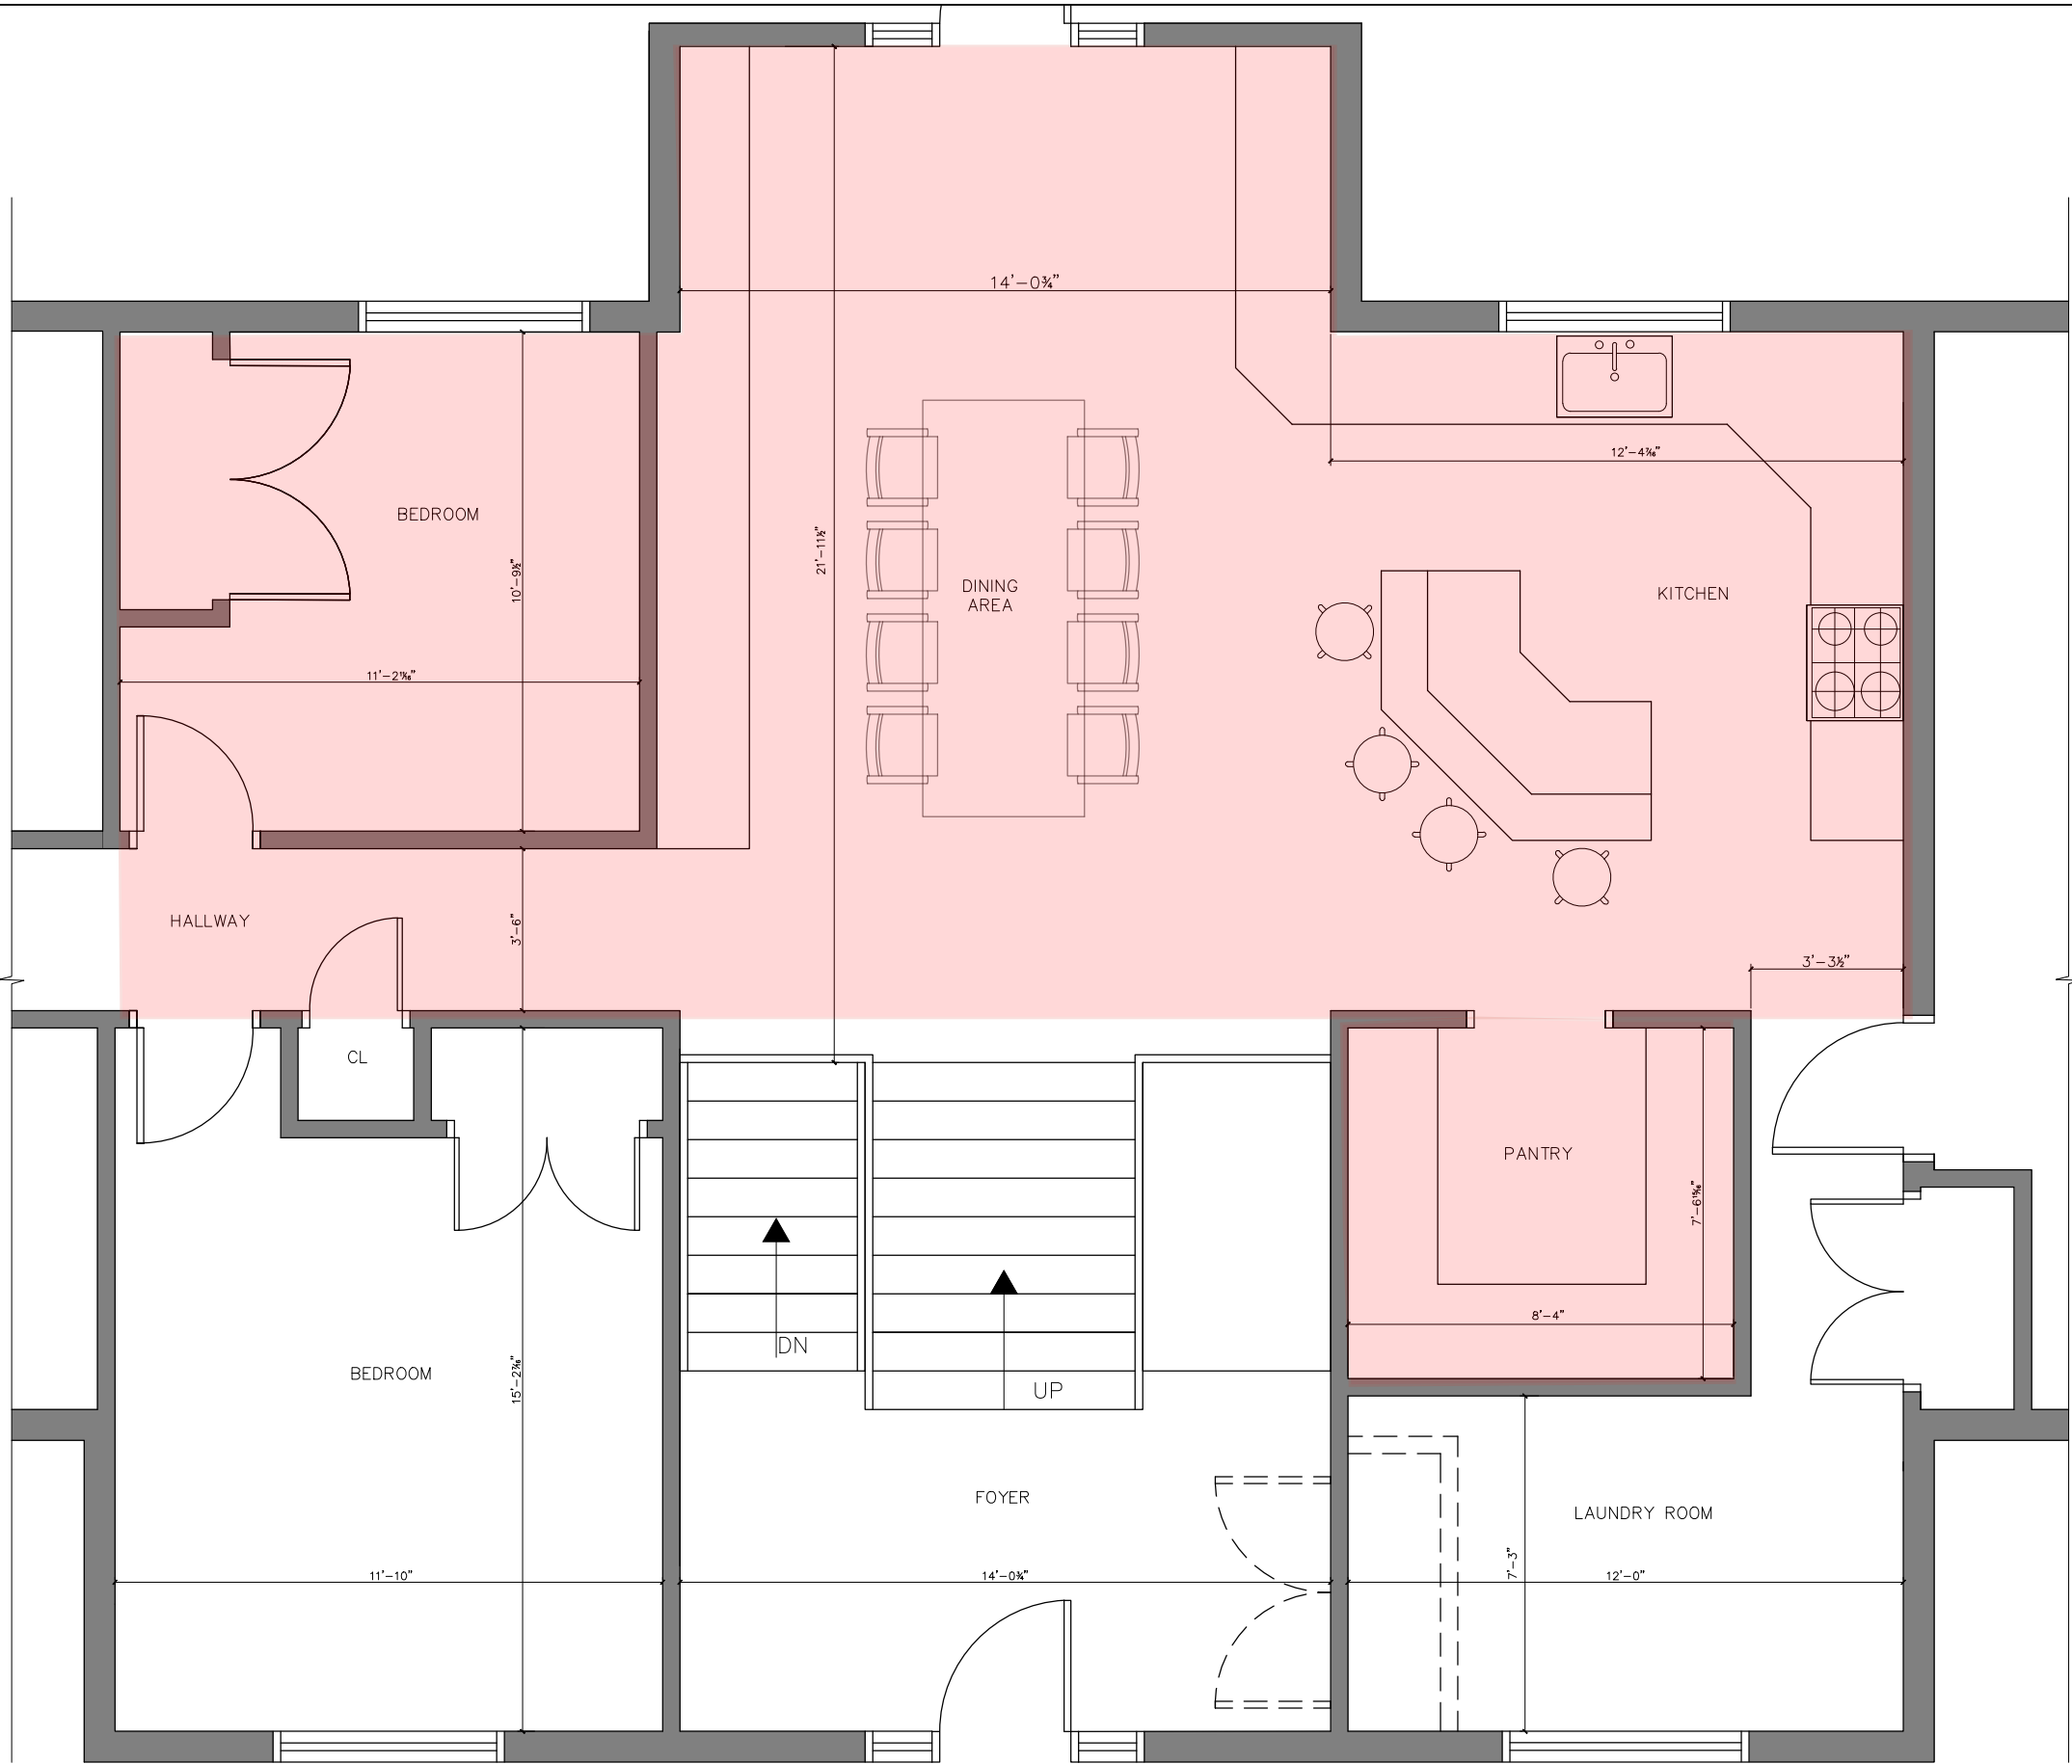

AS BUILT PLAN
SCALE: 1/4" = 1' - 0"

FLOOR PLAN

SCALE: 1/4" = 1' - 0"

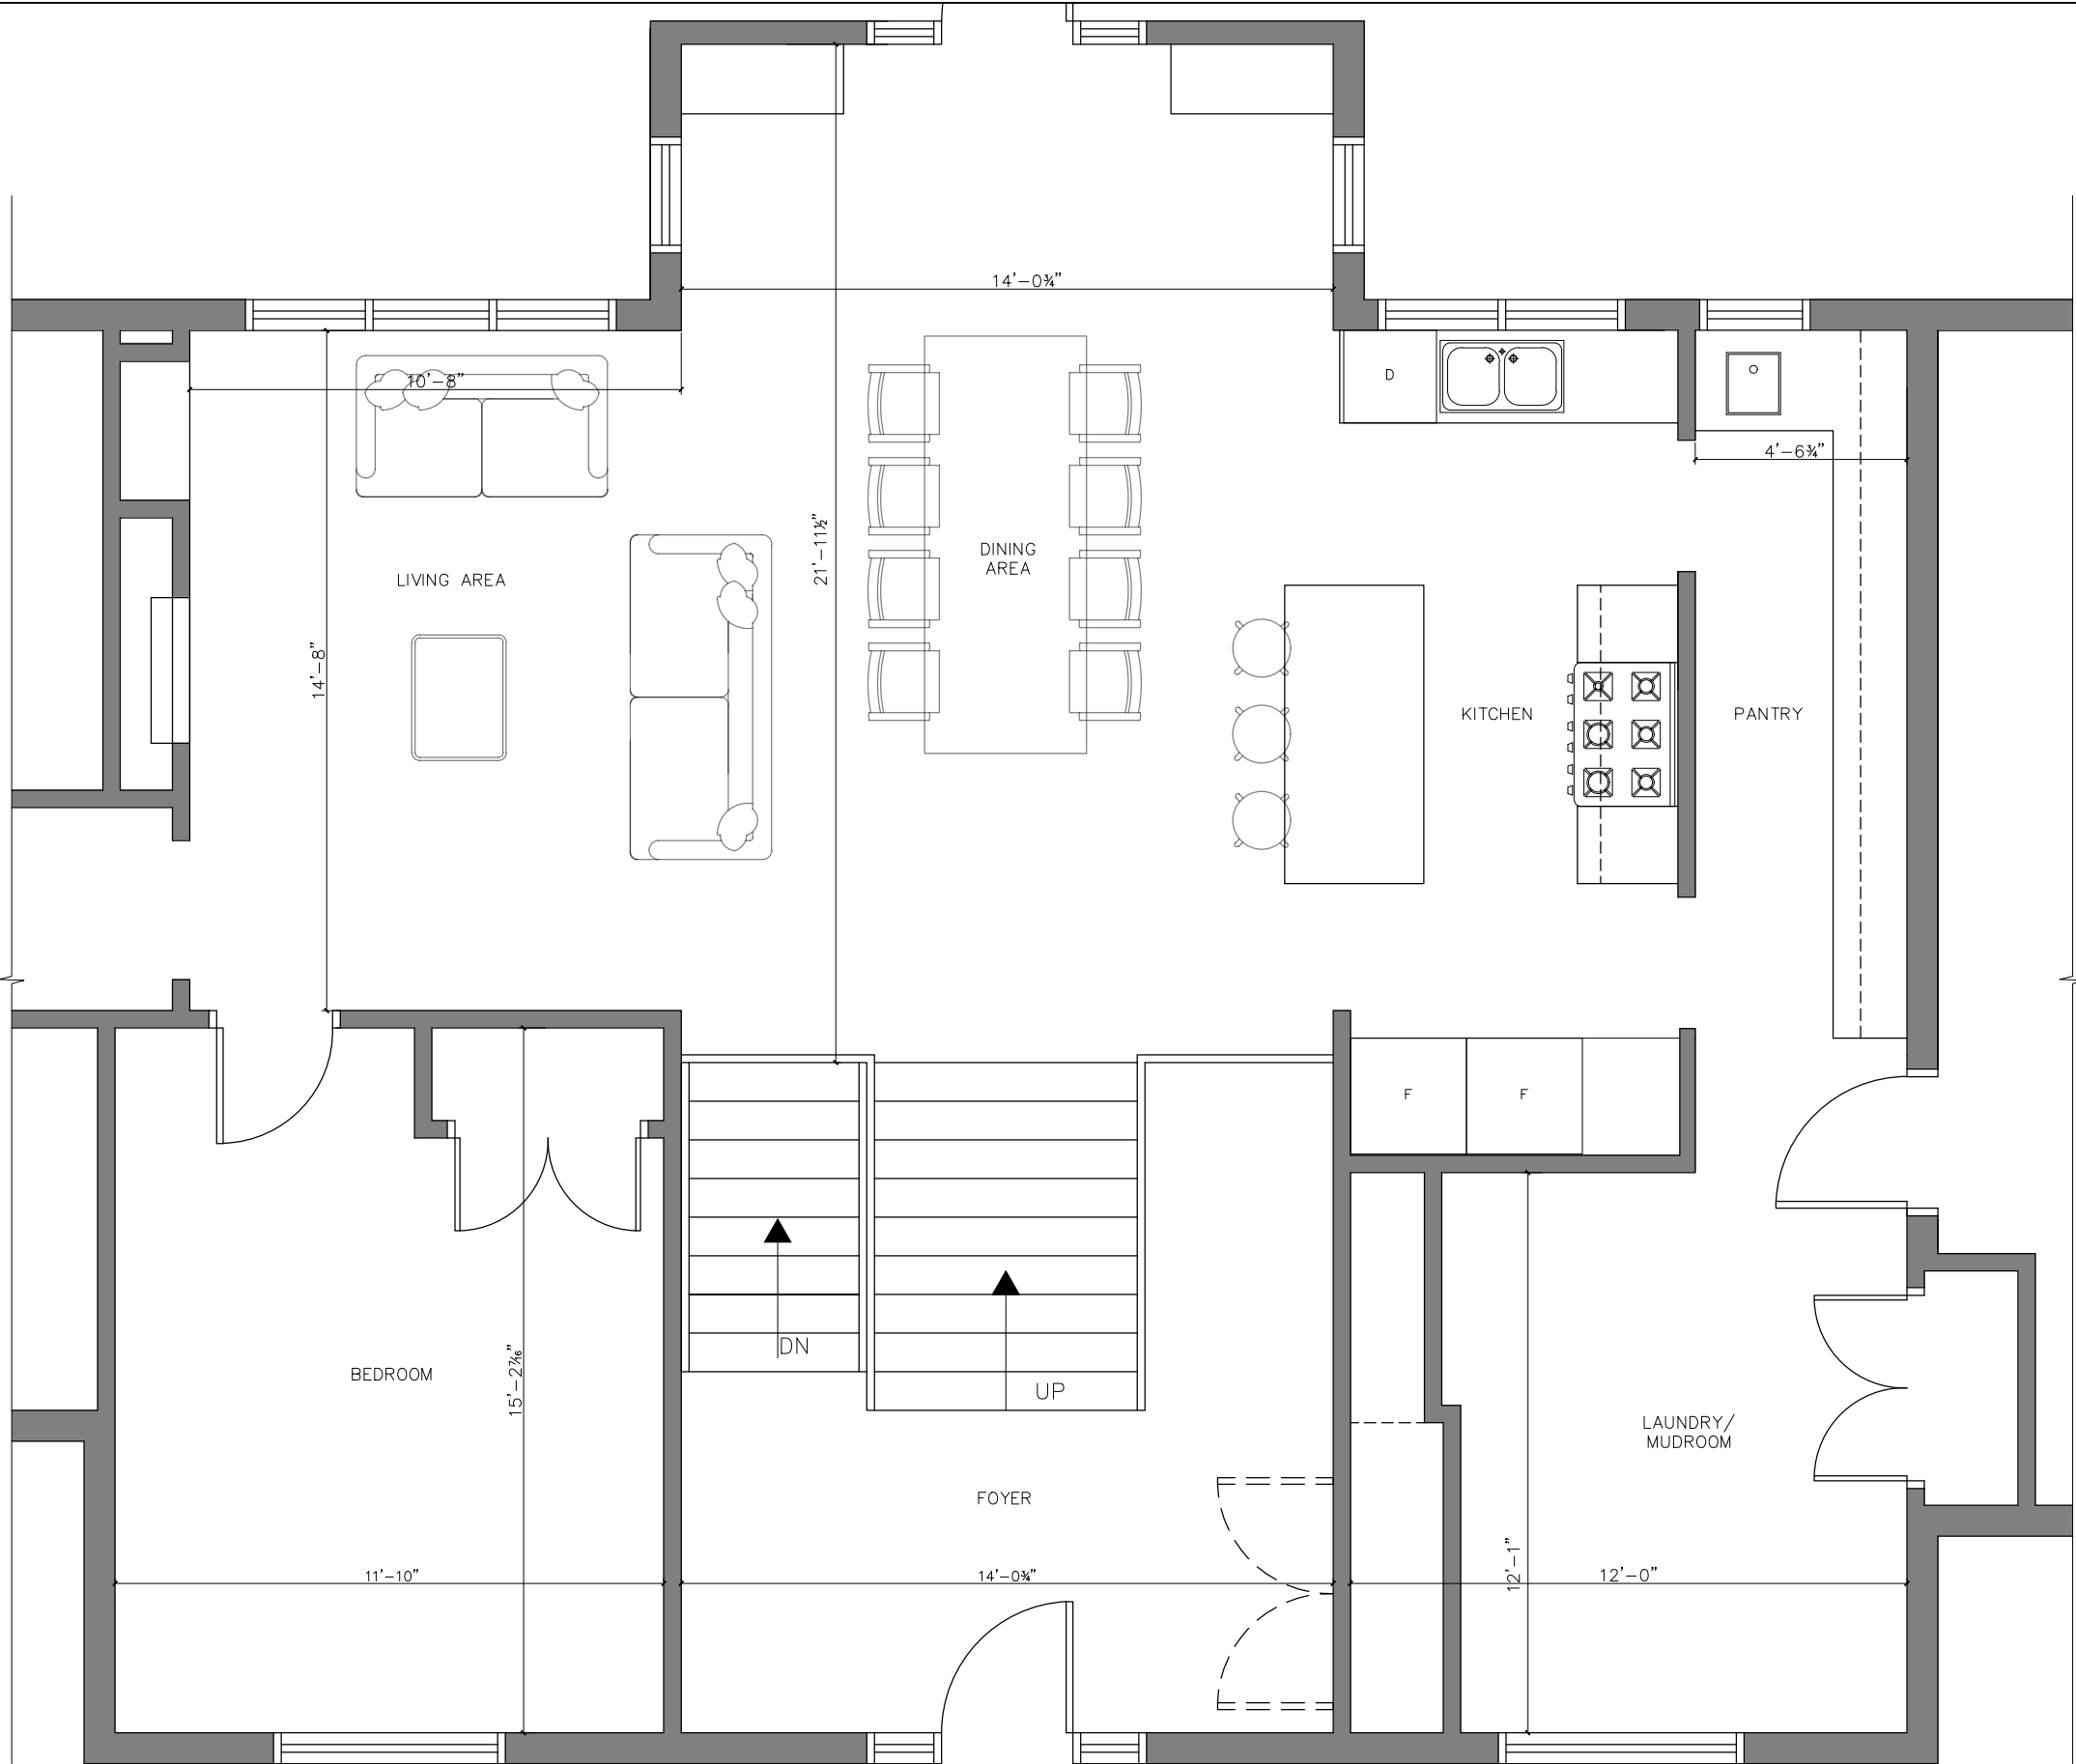

- NOTES:
1. DRAWINGS ARE NOT TO BE SCALED.
 2. THESE DRAWINGS ARE NOT FOR CONSTRUCTION.
 3. ALL DIMENSIONS AND INSTALLATIONS ARE TO BE VERIFIED ON SITE.
 4. VERIFY ANY MISSING OR CONFLICTING DIMENSIONS WITH THE DESIGNER OR GENERAL CONTRACTOR PRIOR TO CONSTRUCTION.

PROJECT:

ADDRESS:
1561 WESTCHESTER
BOURNE

DRAWING TITLE:
PROPOSED
FLOOR PLAN

DATE:
06/29/2026

SCALE:
1/4" = 1'-0"

NORTH:



DRAWING NO:

2 OF 2